


	EXISTING SPACE	EXISTING TO REMAIN OR RELOCATED	NEW	TOTAL
SUPERVISOR / OFFICE MANAGER OFFICES	4	4	12	16
CUBICLES	42	38	0	41
WALK-UP STATIONS	52	36	0	36

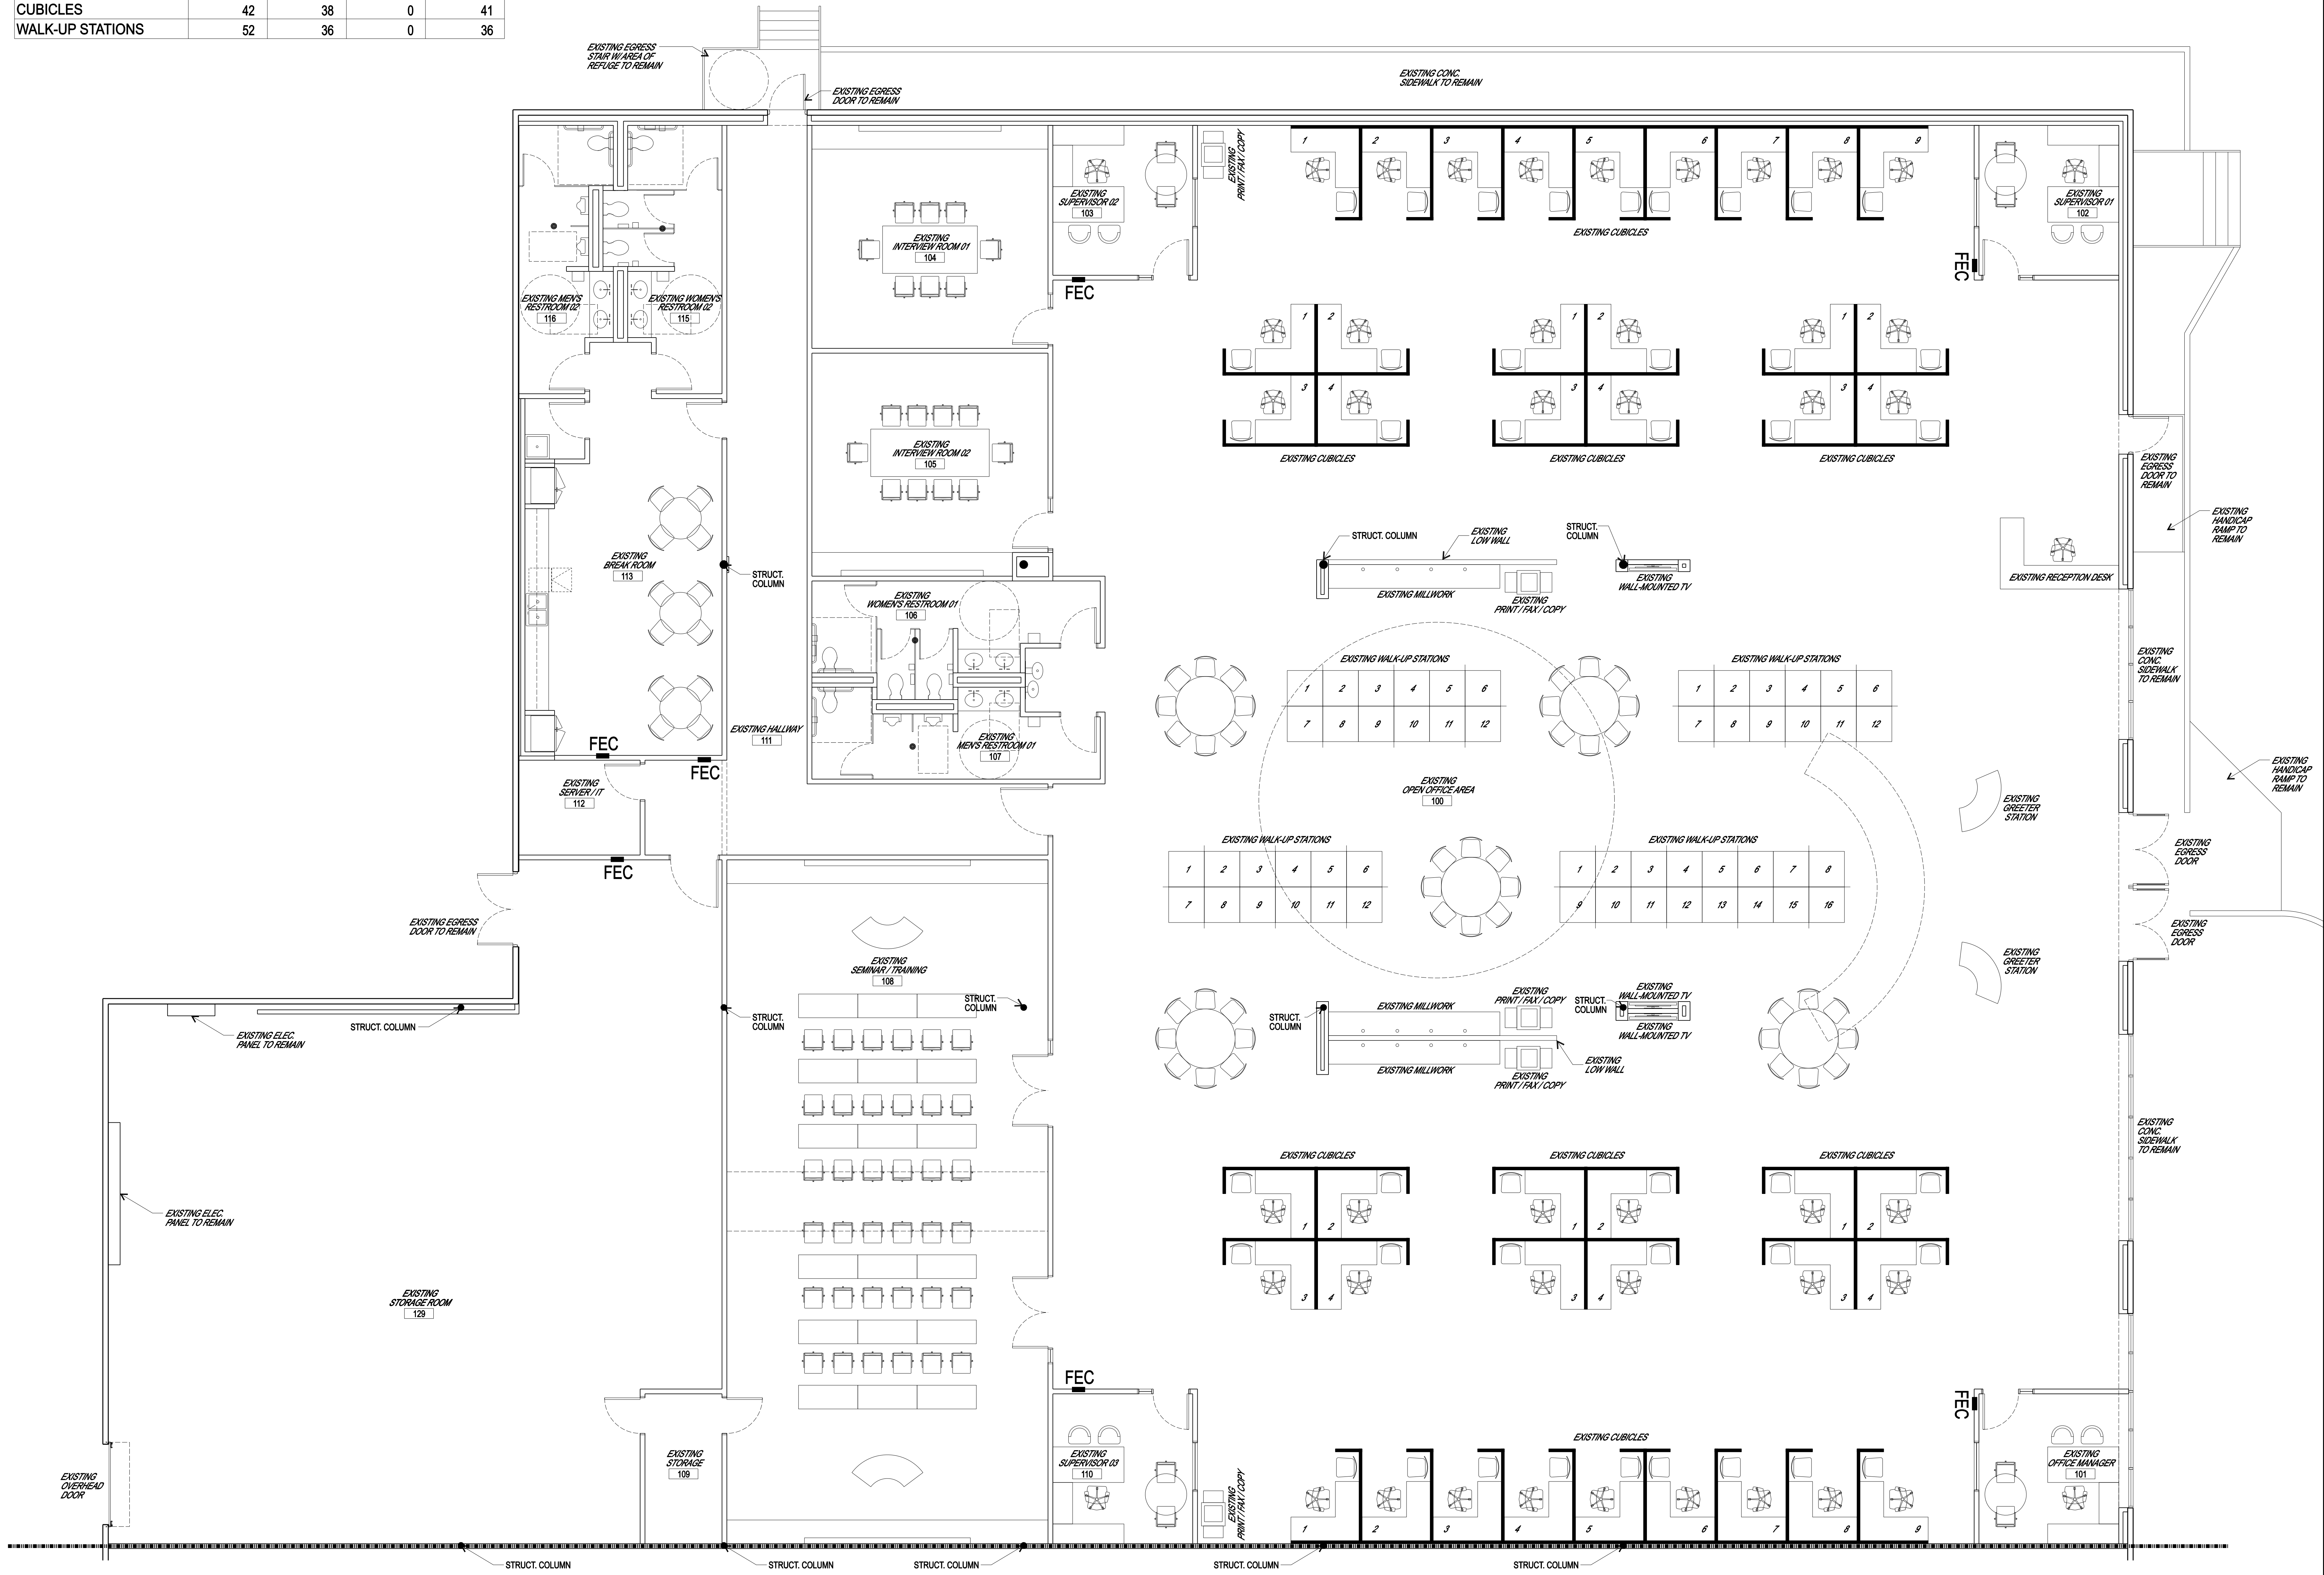

ISSUES AND REVISIONS

DATE	DESCRIPTION
08.14.18	ISSUED FOR PERMITS, PERMITTING & CONSTRUCTION
01	

NM21
 DESIGN STUDIO, LLC
 nathan moore
 936.648.1468
 nathanmoore21@gmail.com



PROJECT NAME:
WORKFORCE SOLUTIONS - SOUTHEAST:
INTERIOR REMODEL

PROJECT ADDRESS:
 12148-B GULF FREEWAY
 HOUSTON, TX. 77034

SHEET NAME:
 AS-BUILT
 FIRST FLOOR PLAN

SHEET NUMBER:
A300

01 AS-BUILT FLOOR PLAN
 SCALE: 3/16" = 1'-0"

